


5 4 3 2 1

C

B

A

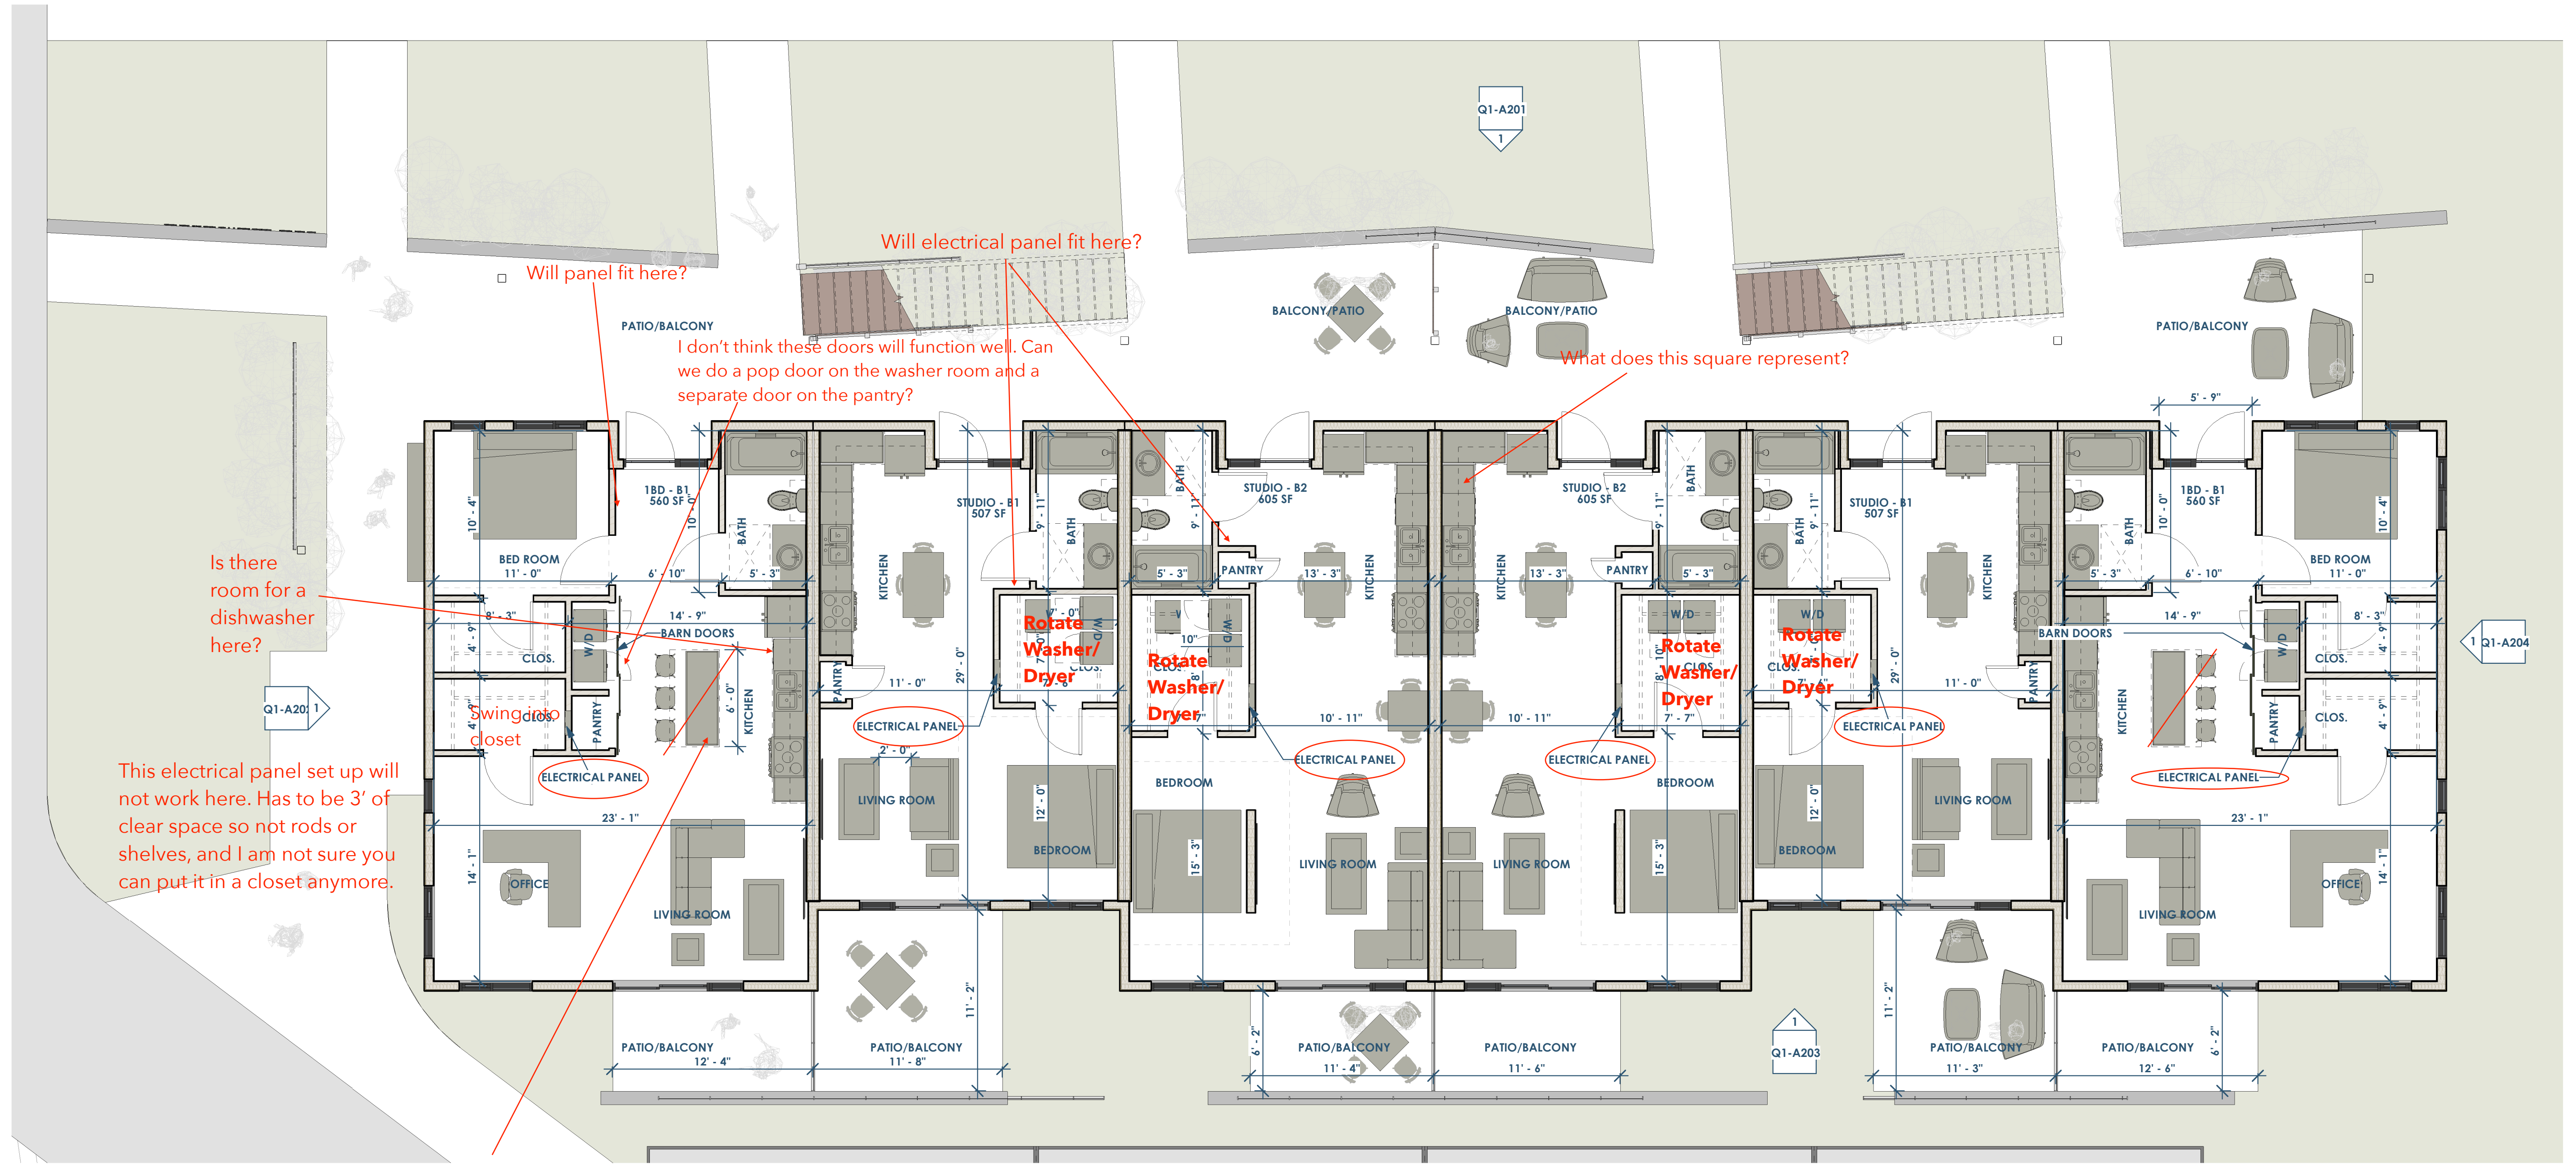

1
Q1-A101
OPTION 1 - FLOOR PLAN - 1ST
3/16" = 1'-0"



Owner: Renovation Wranglers
102 E 26th St
Bryan, TX 77803
Katieneason@me.com | 979.450.9969

Architect of Record: LKB Architecture
2929 Allen Pkwy Suite 200
Houston, TX 77019
lisa@lkbarchitecture.com | 713.425.3076

Architect: Ryan Schultiz - Opening Design
17 S Fairchild St | FL 7
Madison, WI 53703
ryan@openingdesign.com | 773.425.6456

OPTION 1 - FLOOR PLAN - 1ST - 01.24.2022

101 W 33RD STREET

BRYAN, TX 77803

Q1-A101

I am pretty sure electrical panels can't be in a closet

5 4 3 2 1

This project, like most OpeningDesign's projects, is open source. (Attribution-ShareAlike 4.0 International--CC BY-SA 4.0)--freely available to any party for future use, assuming the terms such as Attribution and ShareAlike are honored.

5

4

3

2

1

C


C

B

B

A

A

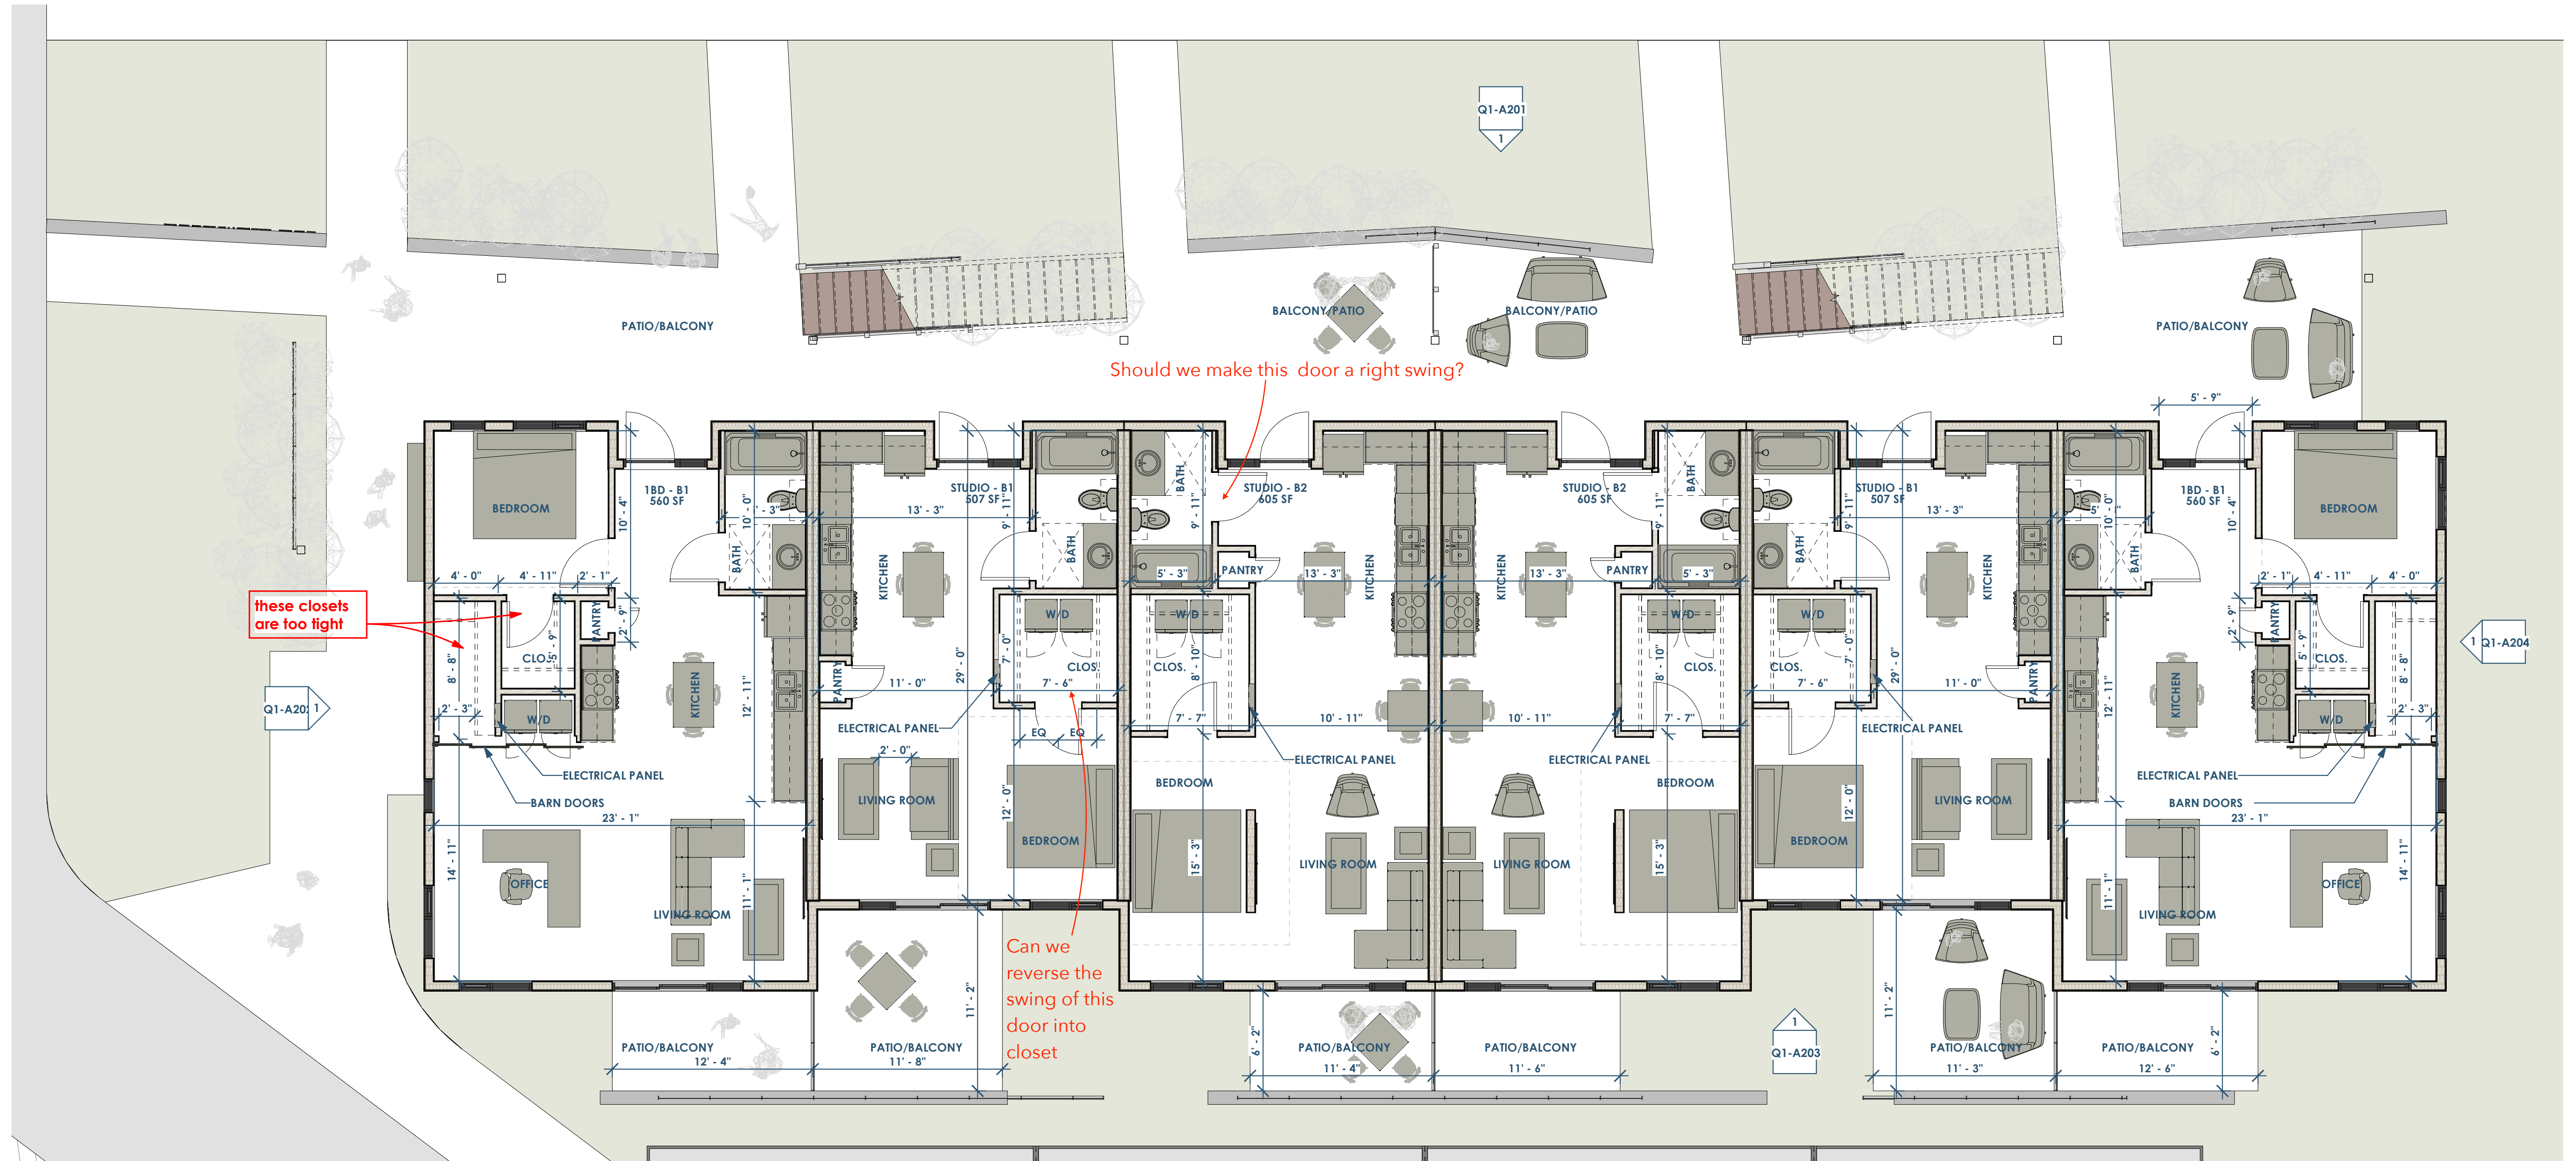

1 OPTION 2 - FLOOR PLAN - 1ST
 Q2-A10 3/16" = 1'-0"

This project, like most OpeningDesign's projects, is open source. (Attribution-ShareAlike 4.0 International - CC BY-SA 4.0) - freely available to any party for future use, assuming the terms such as Attribution and ShareAlike are honored.